

US 29 IS ASSUMED TO RUN
IN A NORTH-SOUTH DIRECTION

19
University Rd 001 E
D3-2
VARIABLE X 18"

27
Colesville Rd 10100
D3-2
VARIABLE X 18"

24
EAST WEST
NORTH SOUTH
PM-1
8.5' X 6'

17
R3-3B
36"x36"

22,23
NO TURNS
R3-3
24' x 24'

18
YIELD
TO PEDS
R9-1mod
48" x 48"

25
ONLY
R3-5R
30' x 36"

26
ONLY
R3-5L
30' x 36"

16,19
ONE WAY
R6-1(R)
36' x 30'

20,21
ONE WAY
R6-1(L)
36' x 30'


PUSH BUTTON
TO CROSS
START CROSSING
WATCH FOR
TURNING CARS
DON'T START
UNTIL GREEN
PEDESTRIANS
SHOULD NOT BE
IN CROSSWALK
R10-3C
9' x 12"

EXISTING SIGNALS

1-7
R
Y
G
12"

8-15
12"

PHASING

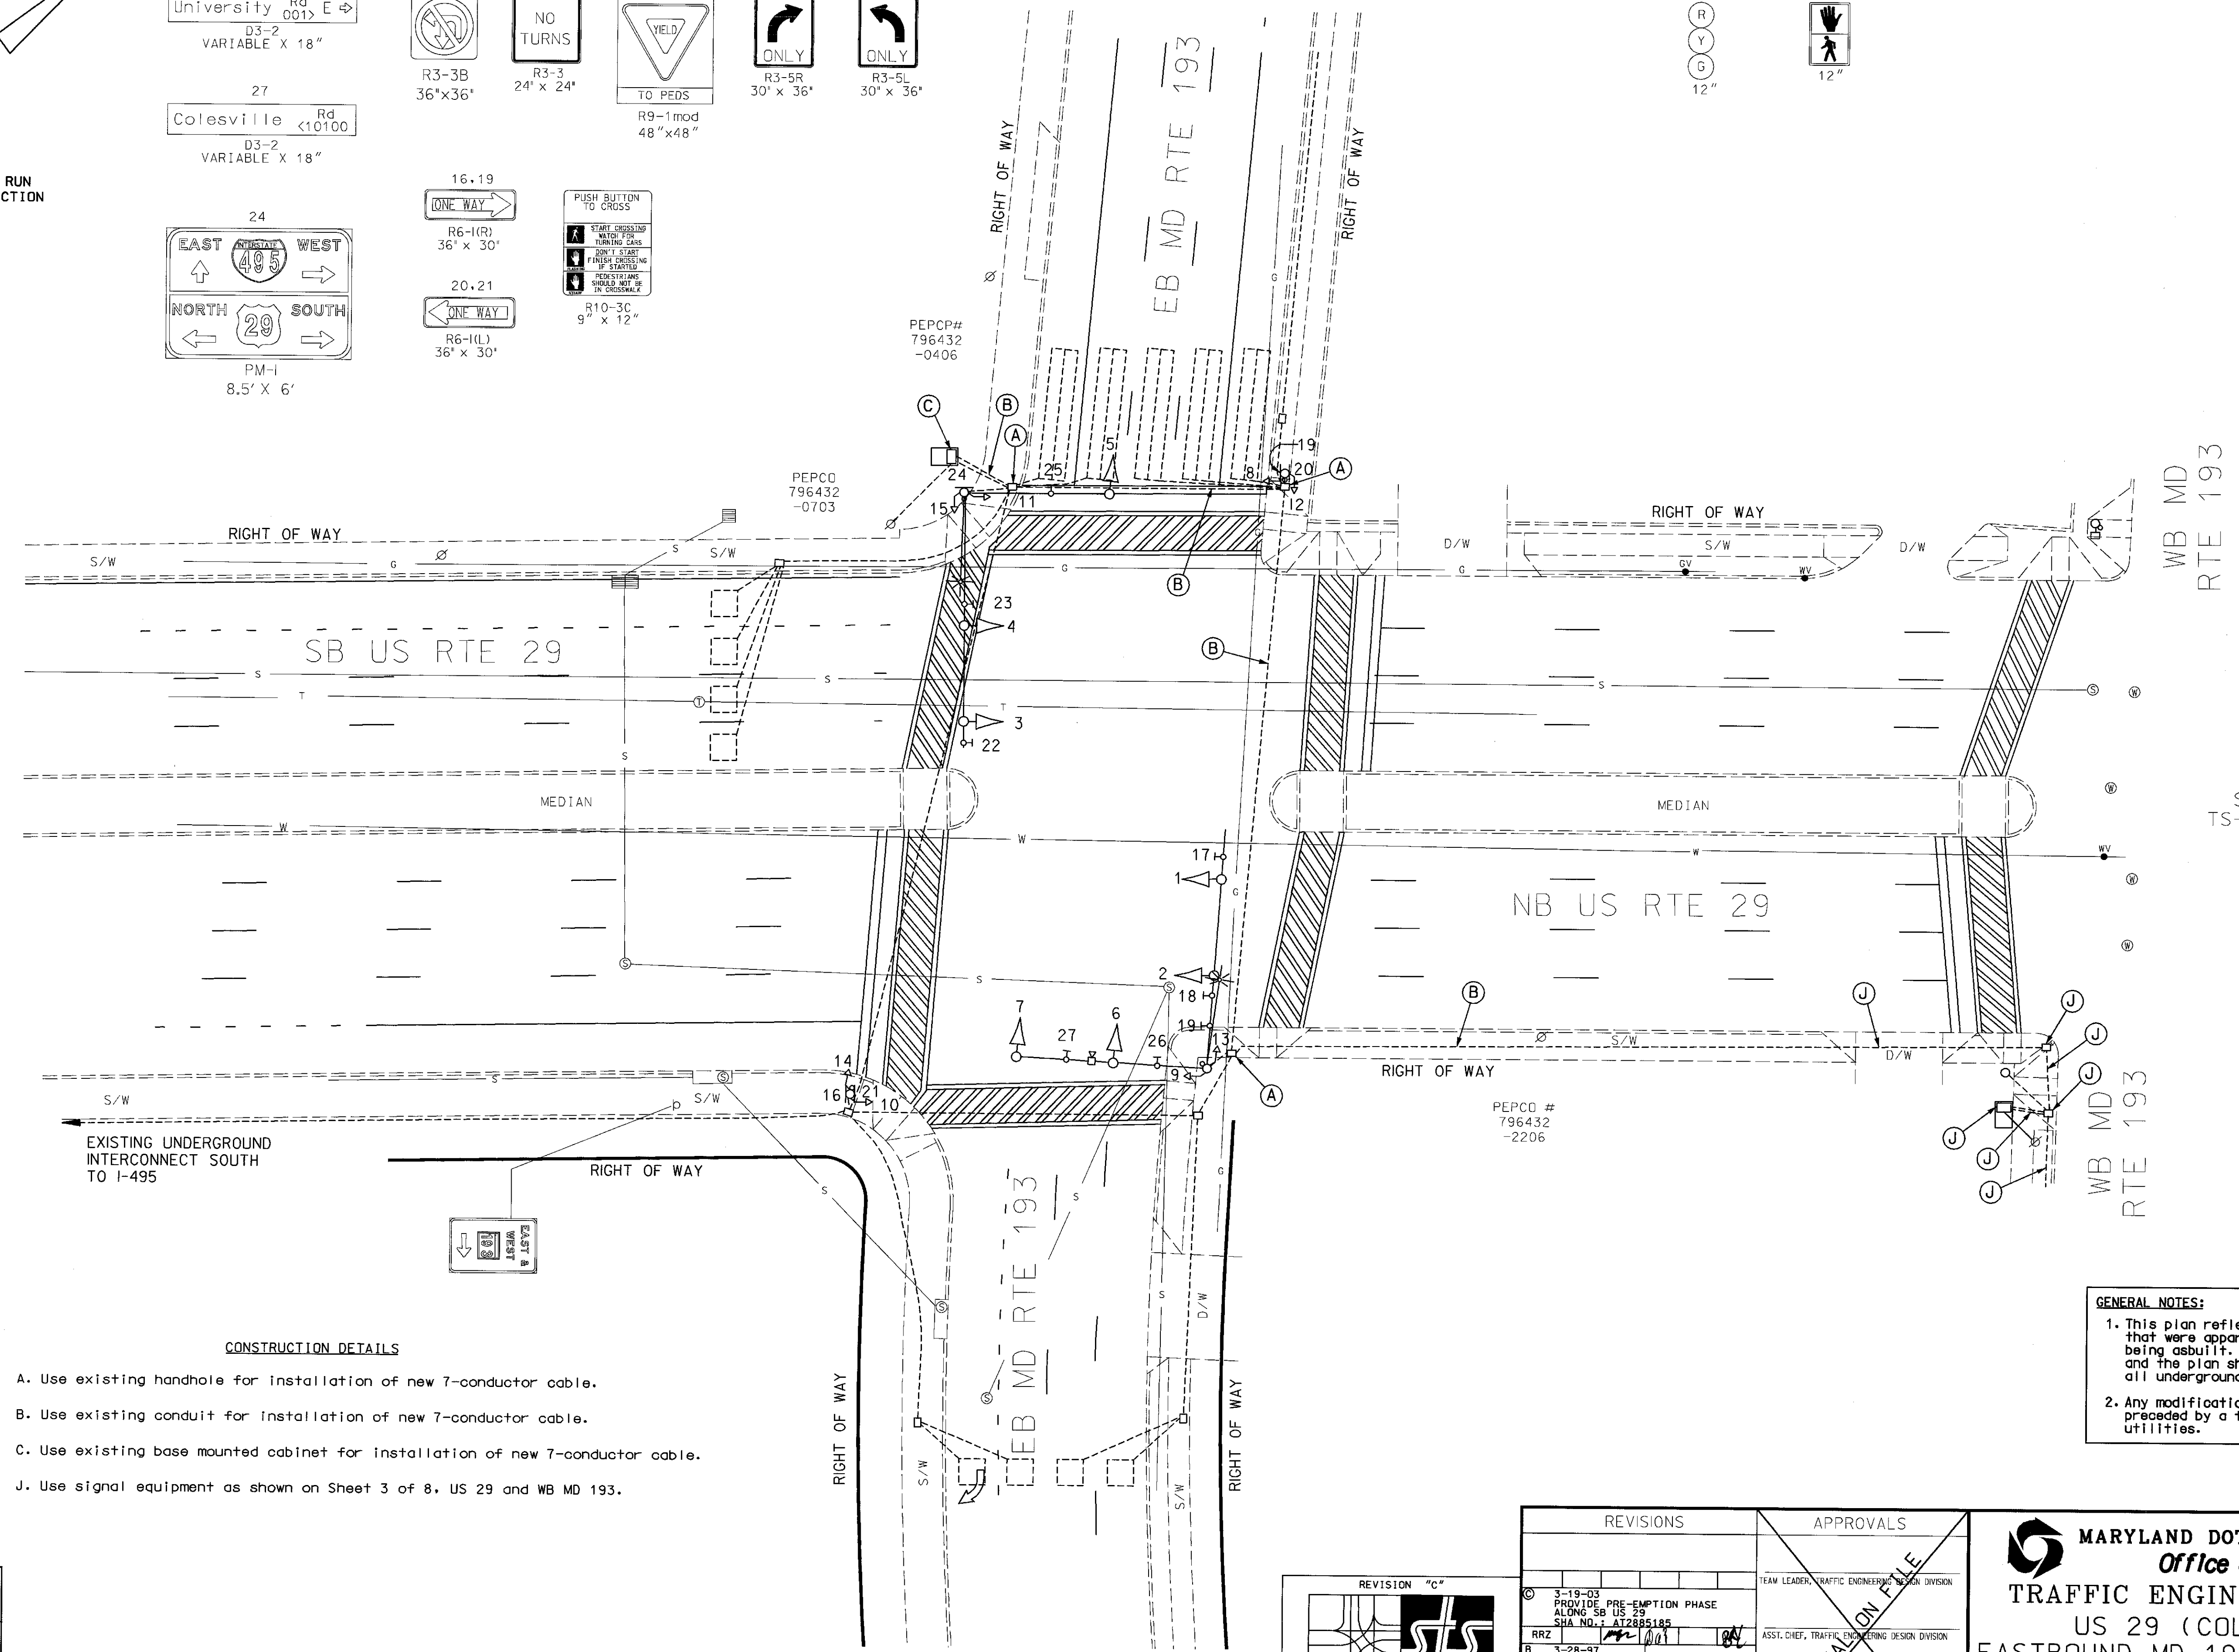

SEE
TS-487B

- CONSTRUCTION DETAILS
- A. Use existing handhole for installation of new 7-conductor cable.
 - B. Use existing conduit for installation of new 7-conductor cable.
 - C. Use existing base mounted cabinet for installation of new 7-conductor cable.
 - J. Use signal equipment as shown on Sheet 3 of 8, US 29 and WB MD 193.

GENERAL NOTES:

1. This plan reflects only those underground utilities that were apparent at the time of this location being asbuilt. A detailed review was not undertaken and the plan should not be construed as representing all underground utilities in the area.
2. Any modification to this subject signal should be preceded by a thorough identification of all existing utilities.

| GEOMETRIC LEGEND | |
|--|-----|
| PROPOSED | --- |
| EXISTING | --- |
| LEGEND OF UNDERGROUND AND OVERHEAD UTILITIES | |
| AERIAL CABLE | --- |
| ELECTRIC | --- |
| TELEPHONE | --- |
| GAS | --- |
| SEWER | --- |
| WATER | --- |
| CABLE TV | --- |

REVISION "C"

4261d.dgn TASK-66

| REVISIONS | | APPROVALS | |
|-----------|--|--|--|
| 3-19-03 | PROVIDE PRE-EMPTION PHASE ALONG SB US 29 | TEAM LEADER, TRAFFIC ENGINEERING DESIGN DIVISION | |
| 3-28-97 | ASBUILT | ASST. CHIEF, TRAFFIC ENGINEERING DESIGN DIVISION | |
| 9-95 | REVISED FOR THE US 29 IMPROVEMENTS | CHIEF, TRAFFIC ENGINEERING DESIGN DIVISION | |
| | | DIRECTOR, TRAFFIC & SAFETY | |

MARYLAND DOT - STATE HIGHWAY ADMINISTRATION
Office of Traffic & Safety
TRAFFIC ENGINEERING DESIGN DIVISION
US 29 (COLESVILLE ROAD) AND
EASTBOUND MD 193 (UNIVERSITY BLVD EAST)

DRAWN BY: ZAJ
CHECKED BY:
SCALE: 1" = 20'
DATE: 9-95

F.A.P. NO.
S.H.A. NO. M 425-502-370
COUNTY: MONTGOMERY
LOG MILE: 15002902.69

TS NO. 3535 C
T.I.M.S. NO. F 405

SHEET NO. 4 OF 8